
JL.

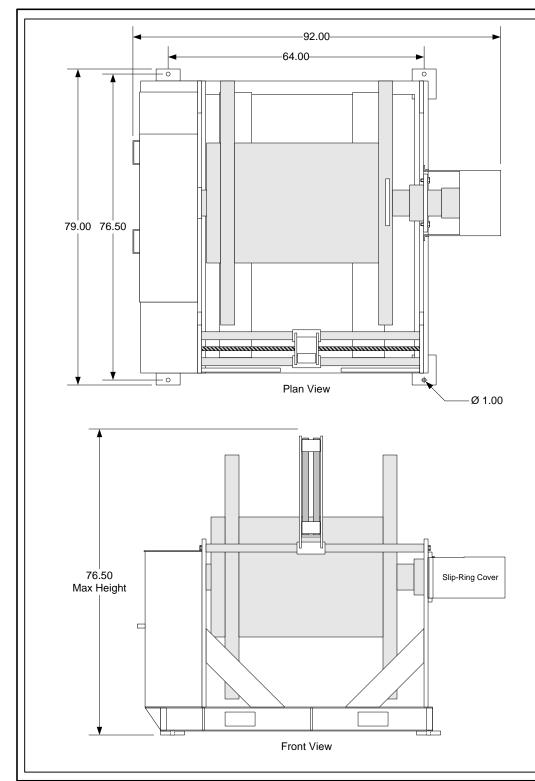

National Underwater Research Technology & Education Center at the University of Connecticut

1080 Shennecossett Road * Groton, CT * 06340 * TEL: 860-405-9121

DT Marine 3030EHALWR Winch (as-built) Mechanical Schematic ~ in support of the K2 ROV

Letter	Drawing No. DTMARINE001			Rev.
Date: April 7, 2010		Scale: 1/2" = 1'	Sheet: 1 of 1	

Winch Weight (w/ROV Umbilical) ~ 5500 lbs

